



SEWER LINE DETAILS

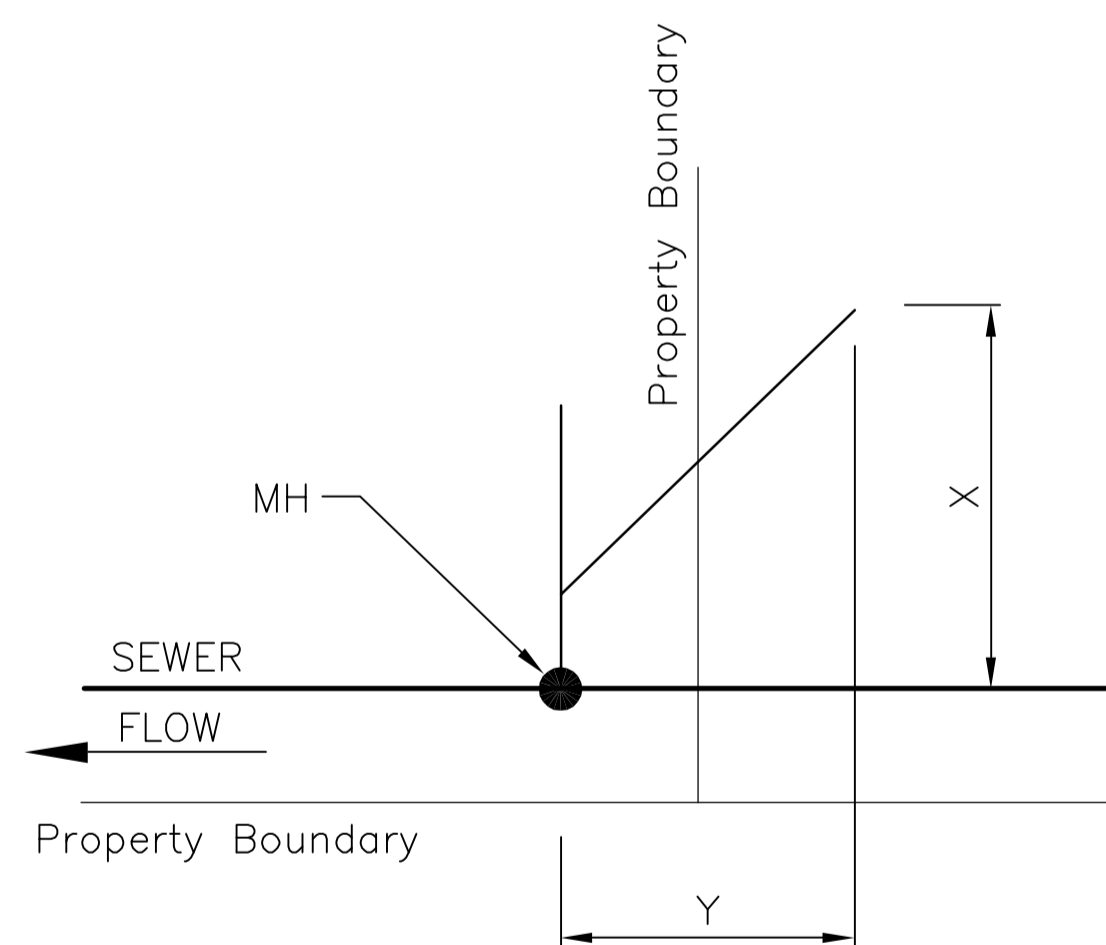

TYPICAL COMBINATION HOUSE CONNECTION

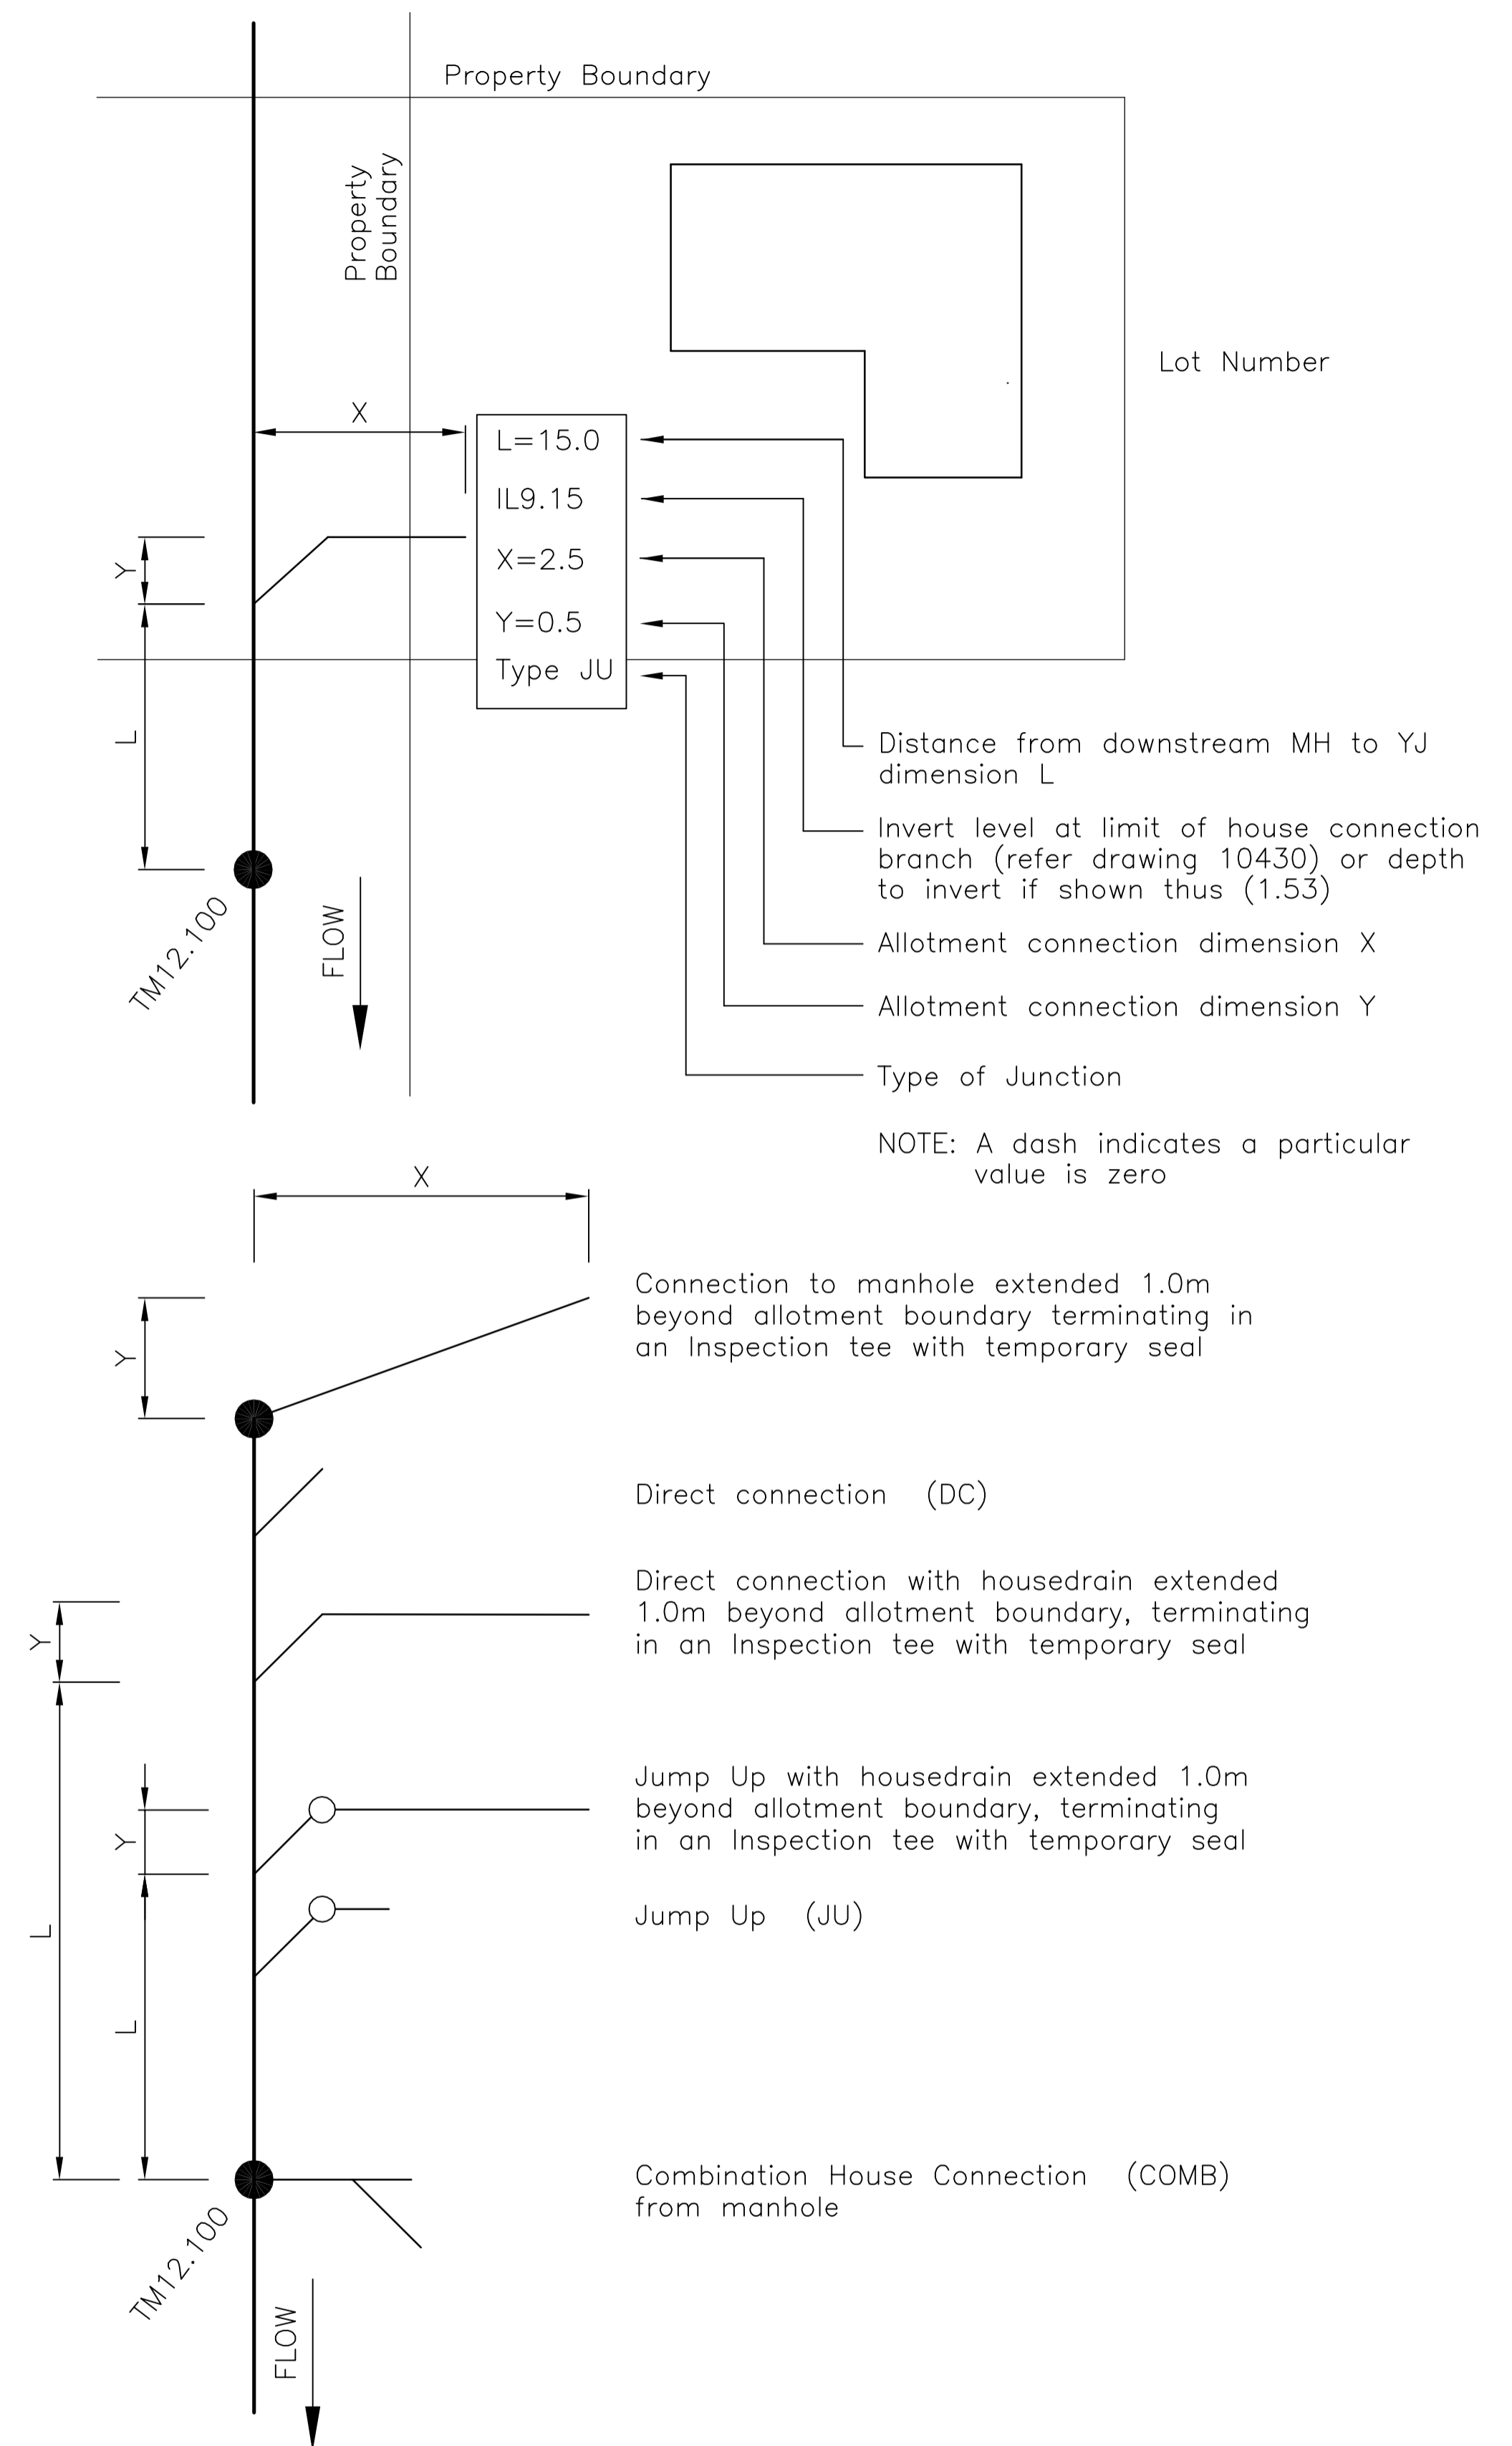

HOUSE DRAIN DETAILS

ALL AS CONSTRUCTED INFORMATION SHALL BE DEPICTED BY AN ASTERISK (*)

NOTES :
Not to Scale
Dimensions and levels in metres unless noted otherwise
Supersedes TS6A and 10024A



THE CITY of
THURINGOWA

86 Thuringowa Drive
Thuringowa Central, QLD, 4817
Phone : (07) 4773 8411
Fax : (07) 4773 8571
Email : council@thuringowa.qld.gov.au
Web : www.thuringowa.qld.gov.au

LEGENDS FOR SEWERAGE DRAWINGS

**STANDARD
DRAWING
SEWERAGE**

10400

No.	DATE	DESCRIPTION	AP'D
B	25/11/2003	Amended to suit current detailing method	cap
A	1/7/1999	ORIGINAL ISSUE	
REVISIONS			

DRAWN: NRM	Engineer Approved: Original Signed by B.Sue	Date: 27/11/2003
CHECKED: WJP	Director Approved: Original Signed by B.Bailey	Date: 27/11/2003

A	B				
---	---	--	--	--	--