
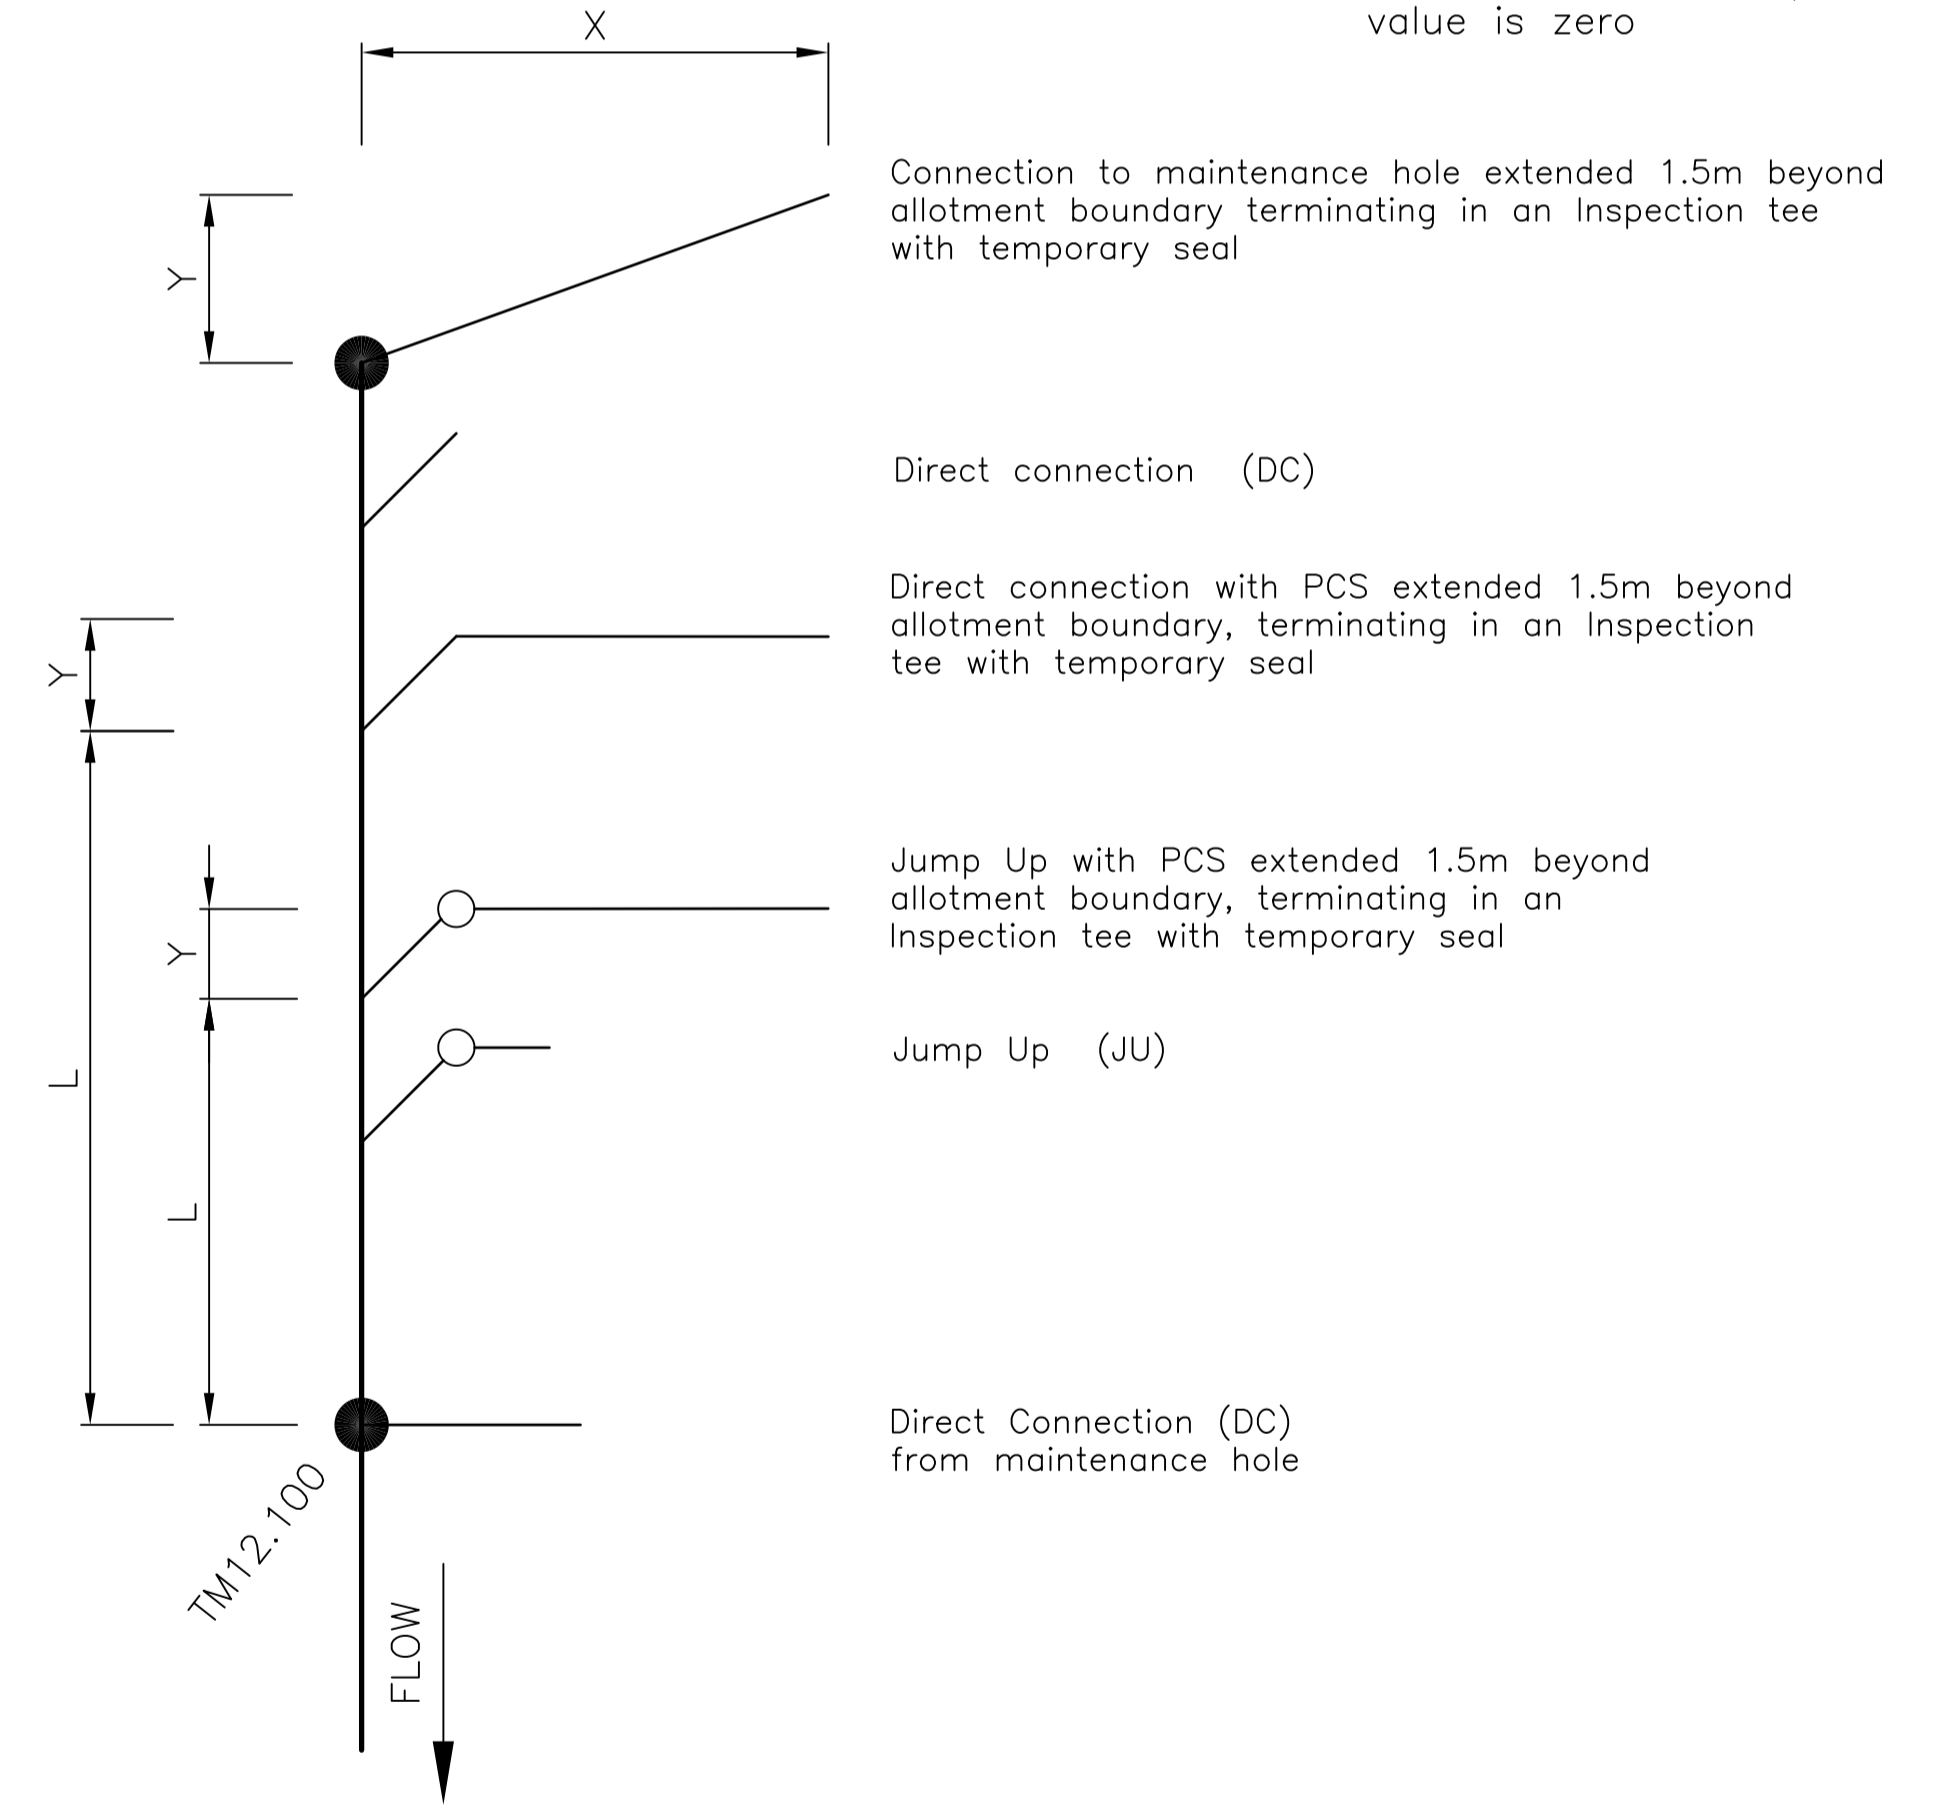


**SEWER LINE DETAILS**

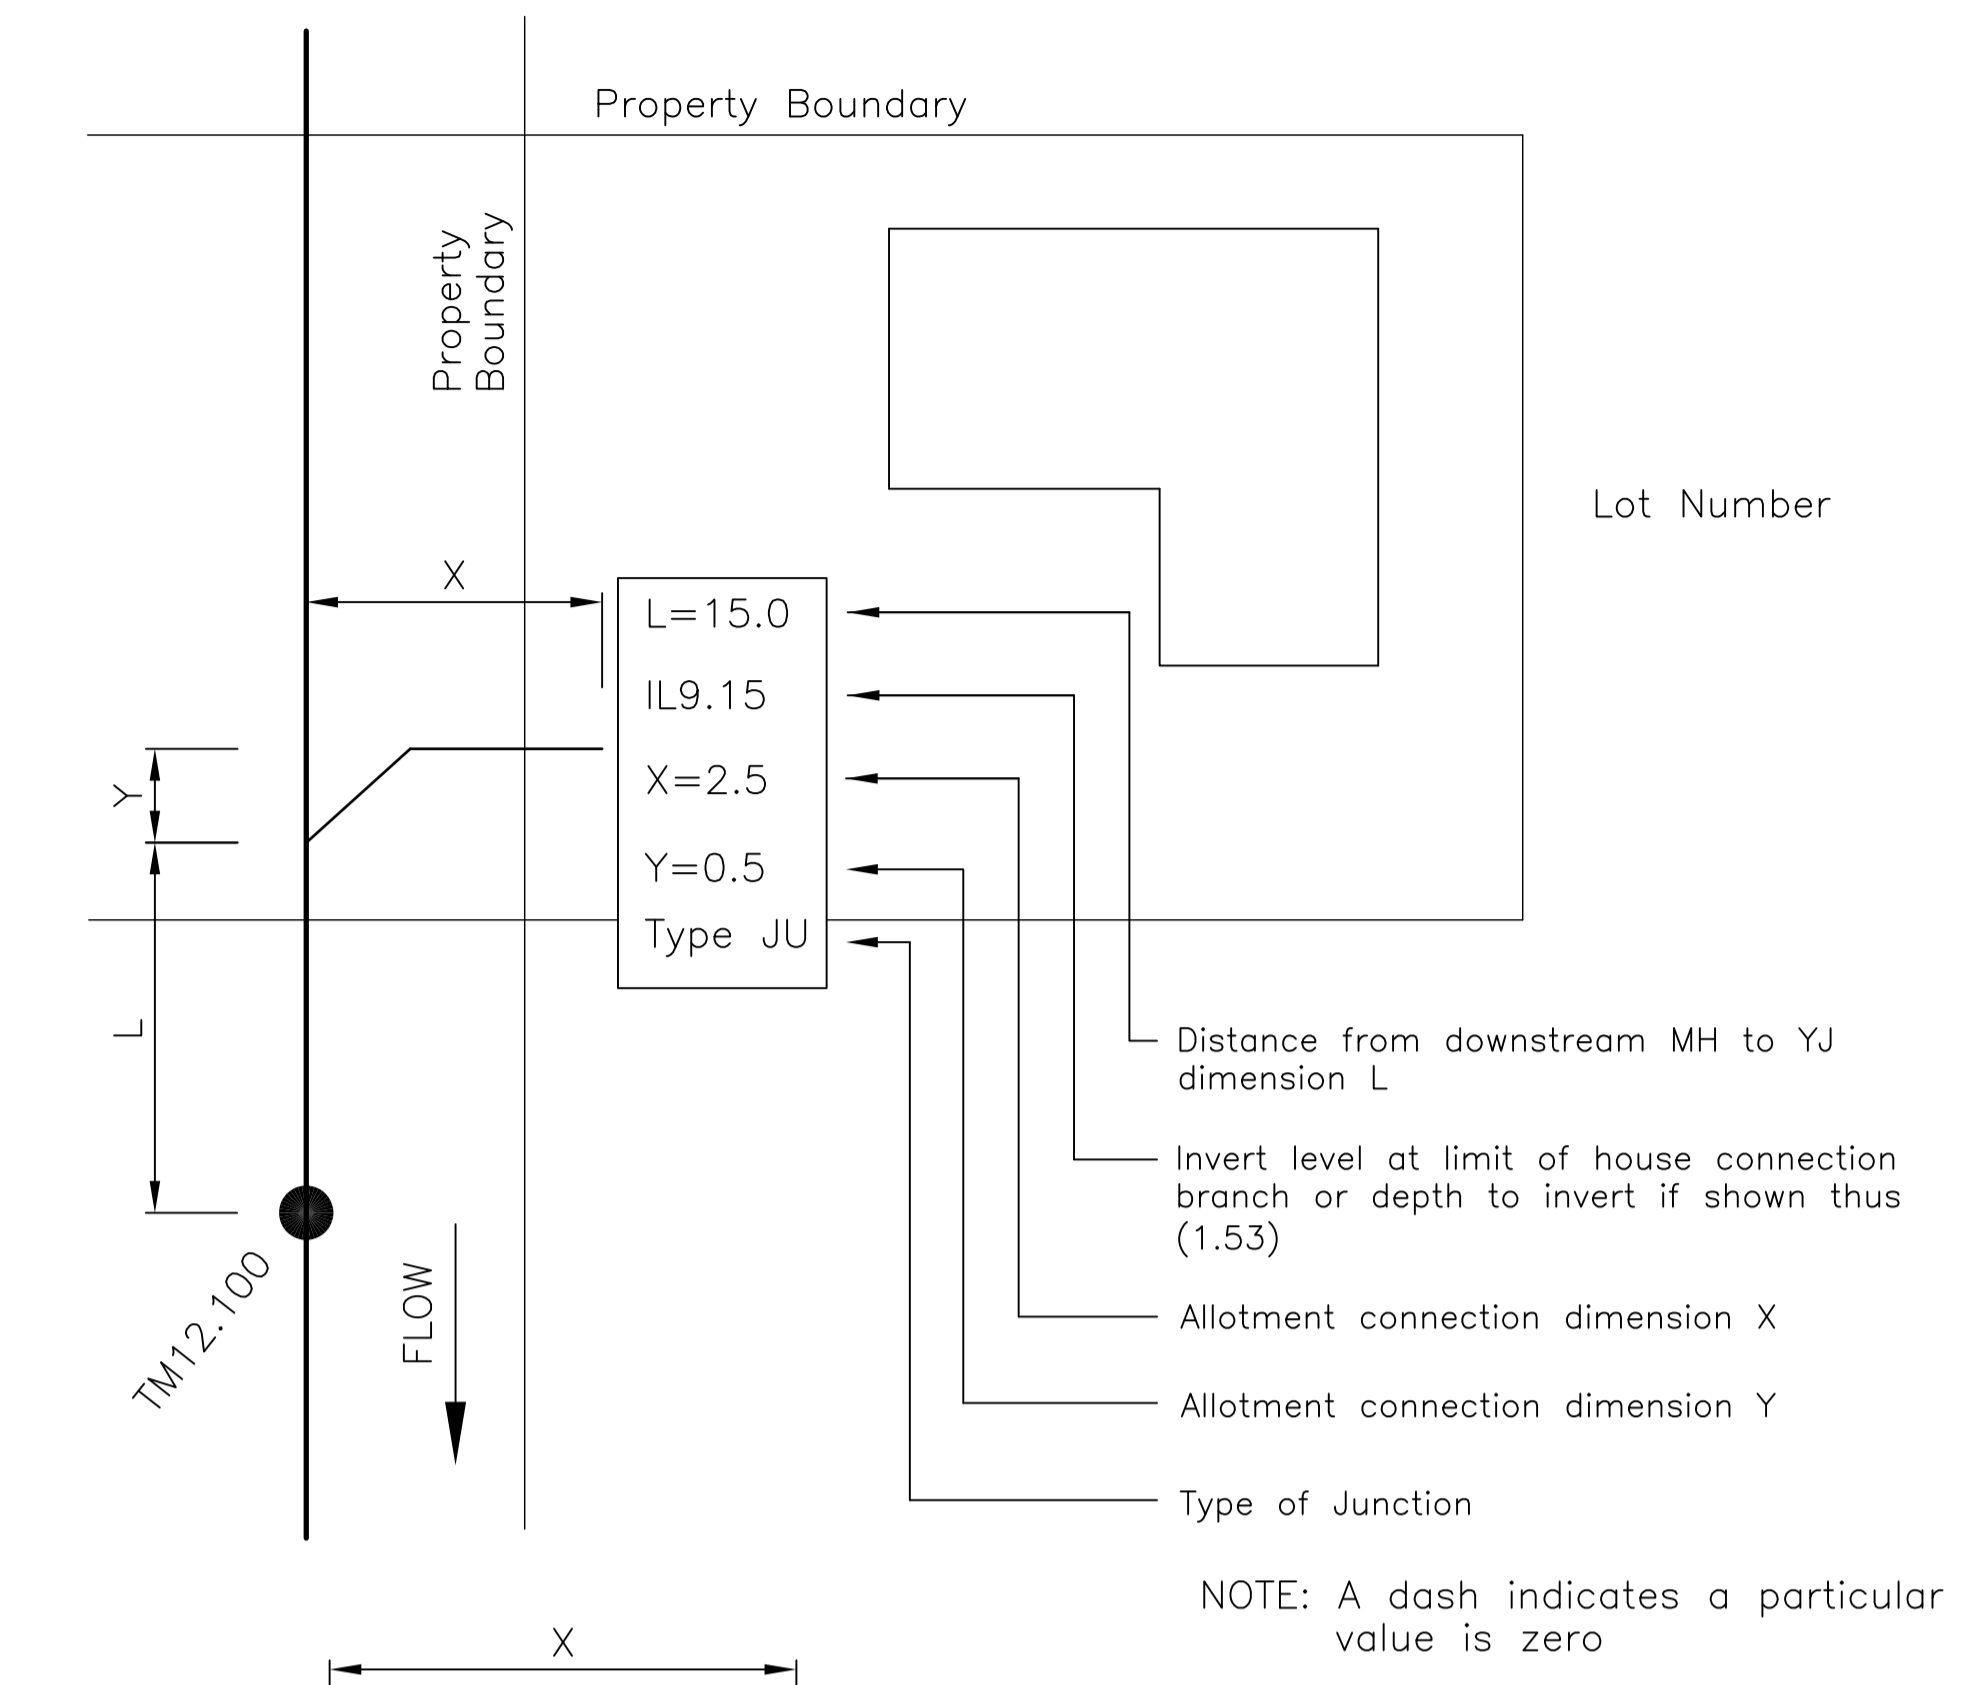

**PROPERTY CONNECTION SEWER (PCS)**

ALL AS CONSTRUCTED INFORMATION SHALL BE DEPICTED BY AN ASTERISK (\*)

No.	DATE	DESCRIPTION	AP'D
REVISIONS			
B		APPEARANCE AMENDED	
A		ORIGINAL ISSUE	

NOTES : ALL DIMENSIONS AND LEVELS IN METRES UNLESS NOTED OTHERWISE

SUPERSEDES TS64, 10024A AND 10400B

Full Size A1

Not to Scale

DRAWN: DESIGN OFFICE


CHECKED: D. MOSELEY

Design Engineer Approved: Original signed by P. TURL

Date: 26/07/2012

Manager Approved: Original signed by P. MENDIOLEA

Date: 26/07/2012

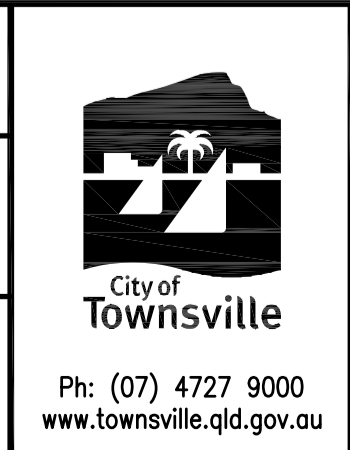

LEGENDS FOR SEWERAGE DRAWINGS

STANDARD DRAWING SEWERAGE

SD-405 B