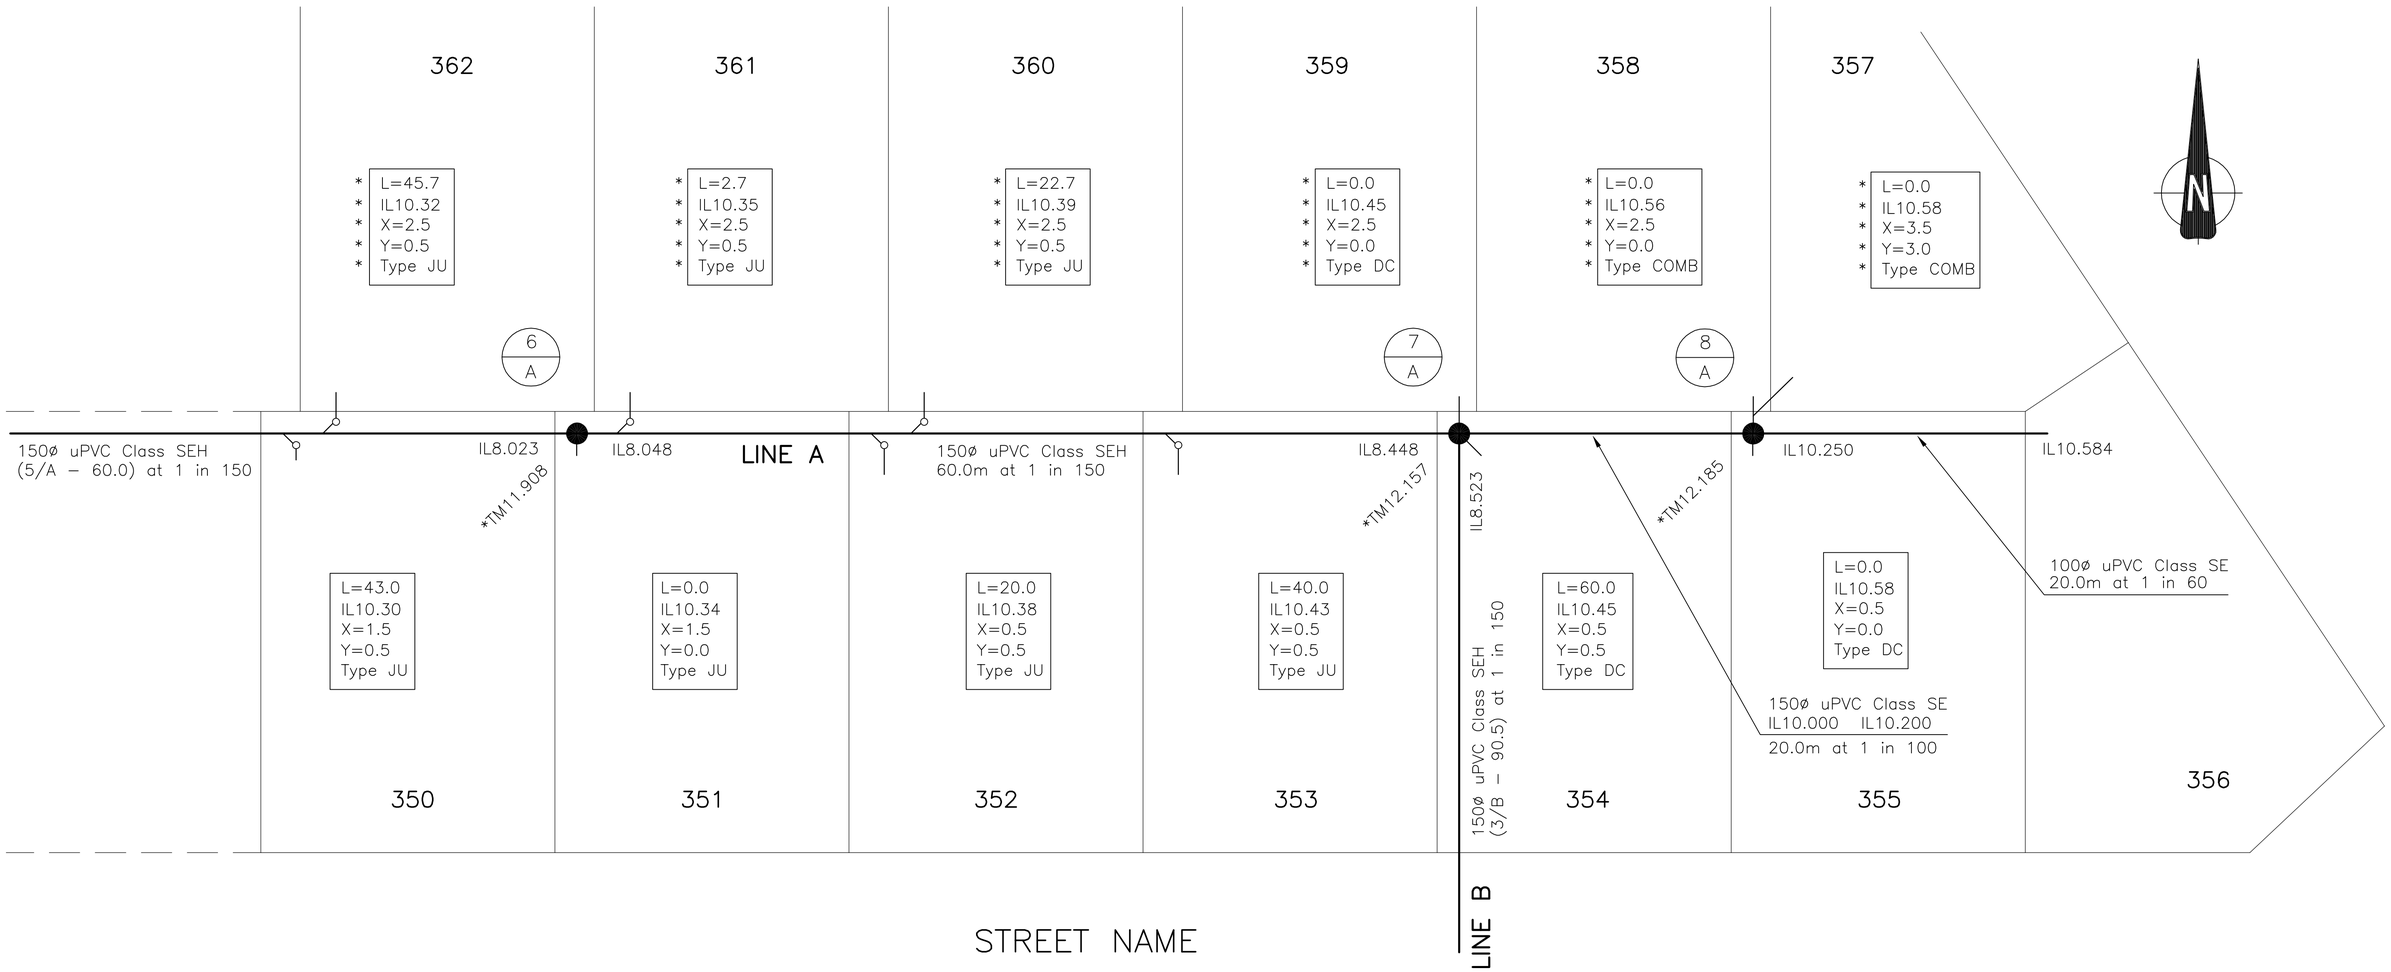

ALL AS CONSTRUCTED INFORMATION SHALL BE DEPICTED BY AN ASTERISK (*)

No.	DATE	DESCRIPTION	AP'D
A	25/11/2003	ORIGINAL ISSUE	

REVISIONS

NOTES :

Not to Scale
Dimensions and Levels in metres unless noted otherwise

THE CITY of THURINGOWA

86 Thuringowa Drive
Thuringowa Central, QLD, 4817
Phone : (07) 4773 8411
Fax : (07) 4773 8571
Email : council@thuringowa.qld.gov.au
Web : www.thuringowa.qld.gov.au

DRAWN: NRM	Engineer Approved: Original Signed by B.Sue	Date: 27/11/2003
CHECKED: WJP	Director Approved: Original Signed by B.Bailey	Date: 27/11/2003

TYPICAL LAYOUT OF SEWERAGE DETAILS

EXAMPLE PLAN

STANDARD DRAWING
SEWERAGE

10401

A